


FED. ROAD DIV. NO.	STATE	FED. AID PROJ. NO.	SHEET NO.	TOTAL SHEETS
3	MD.			

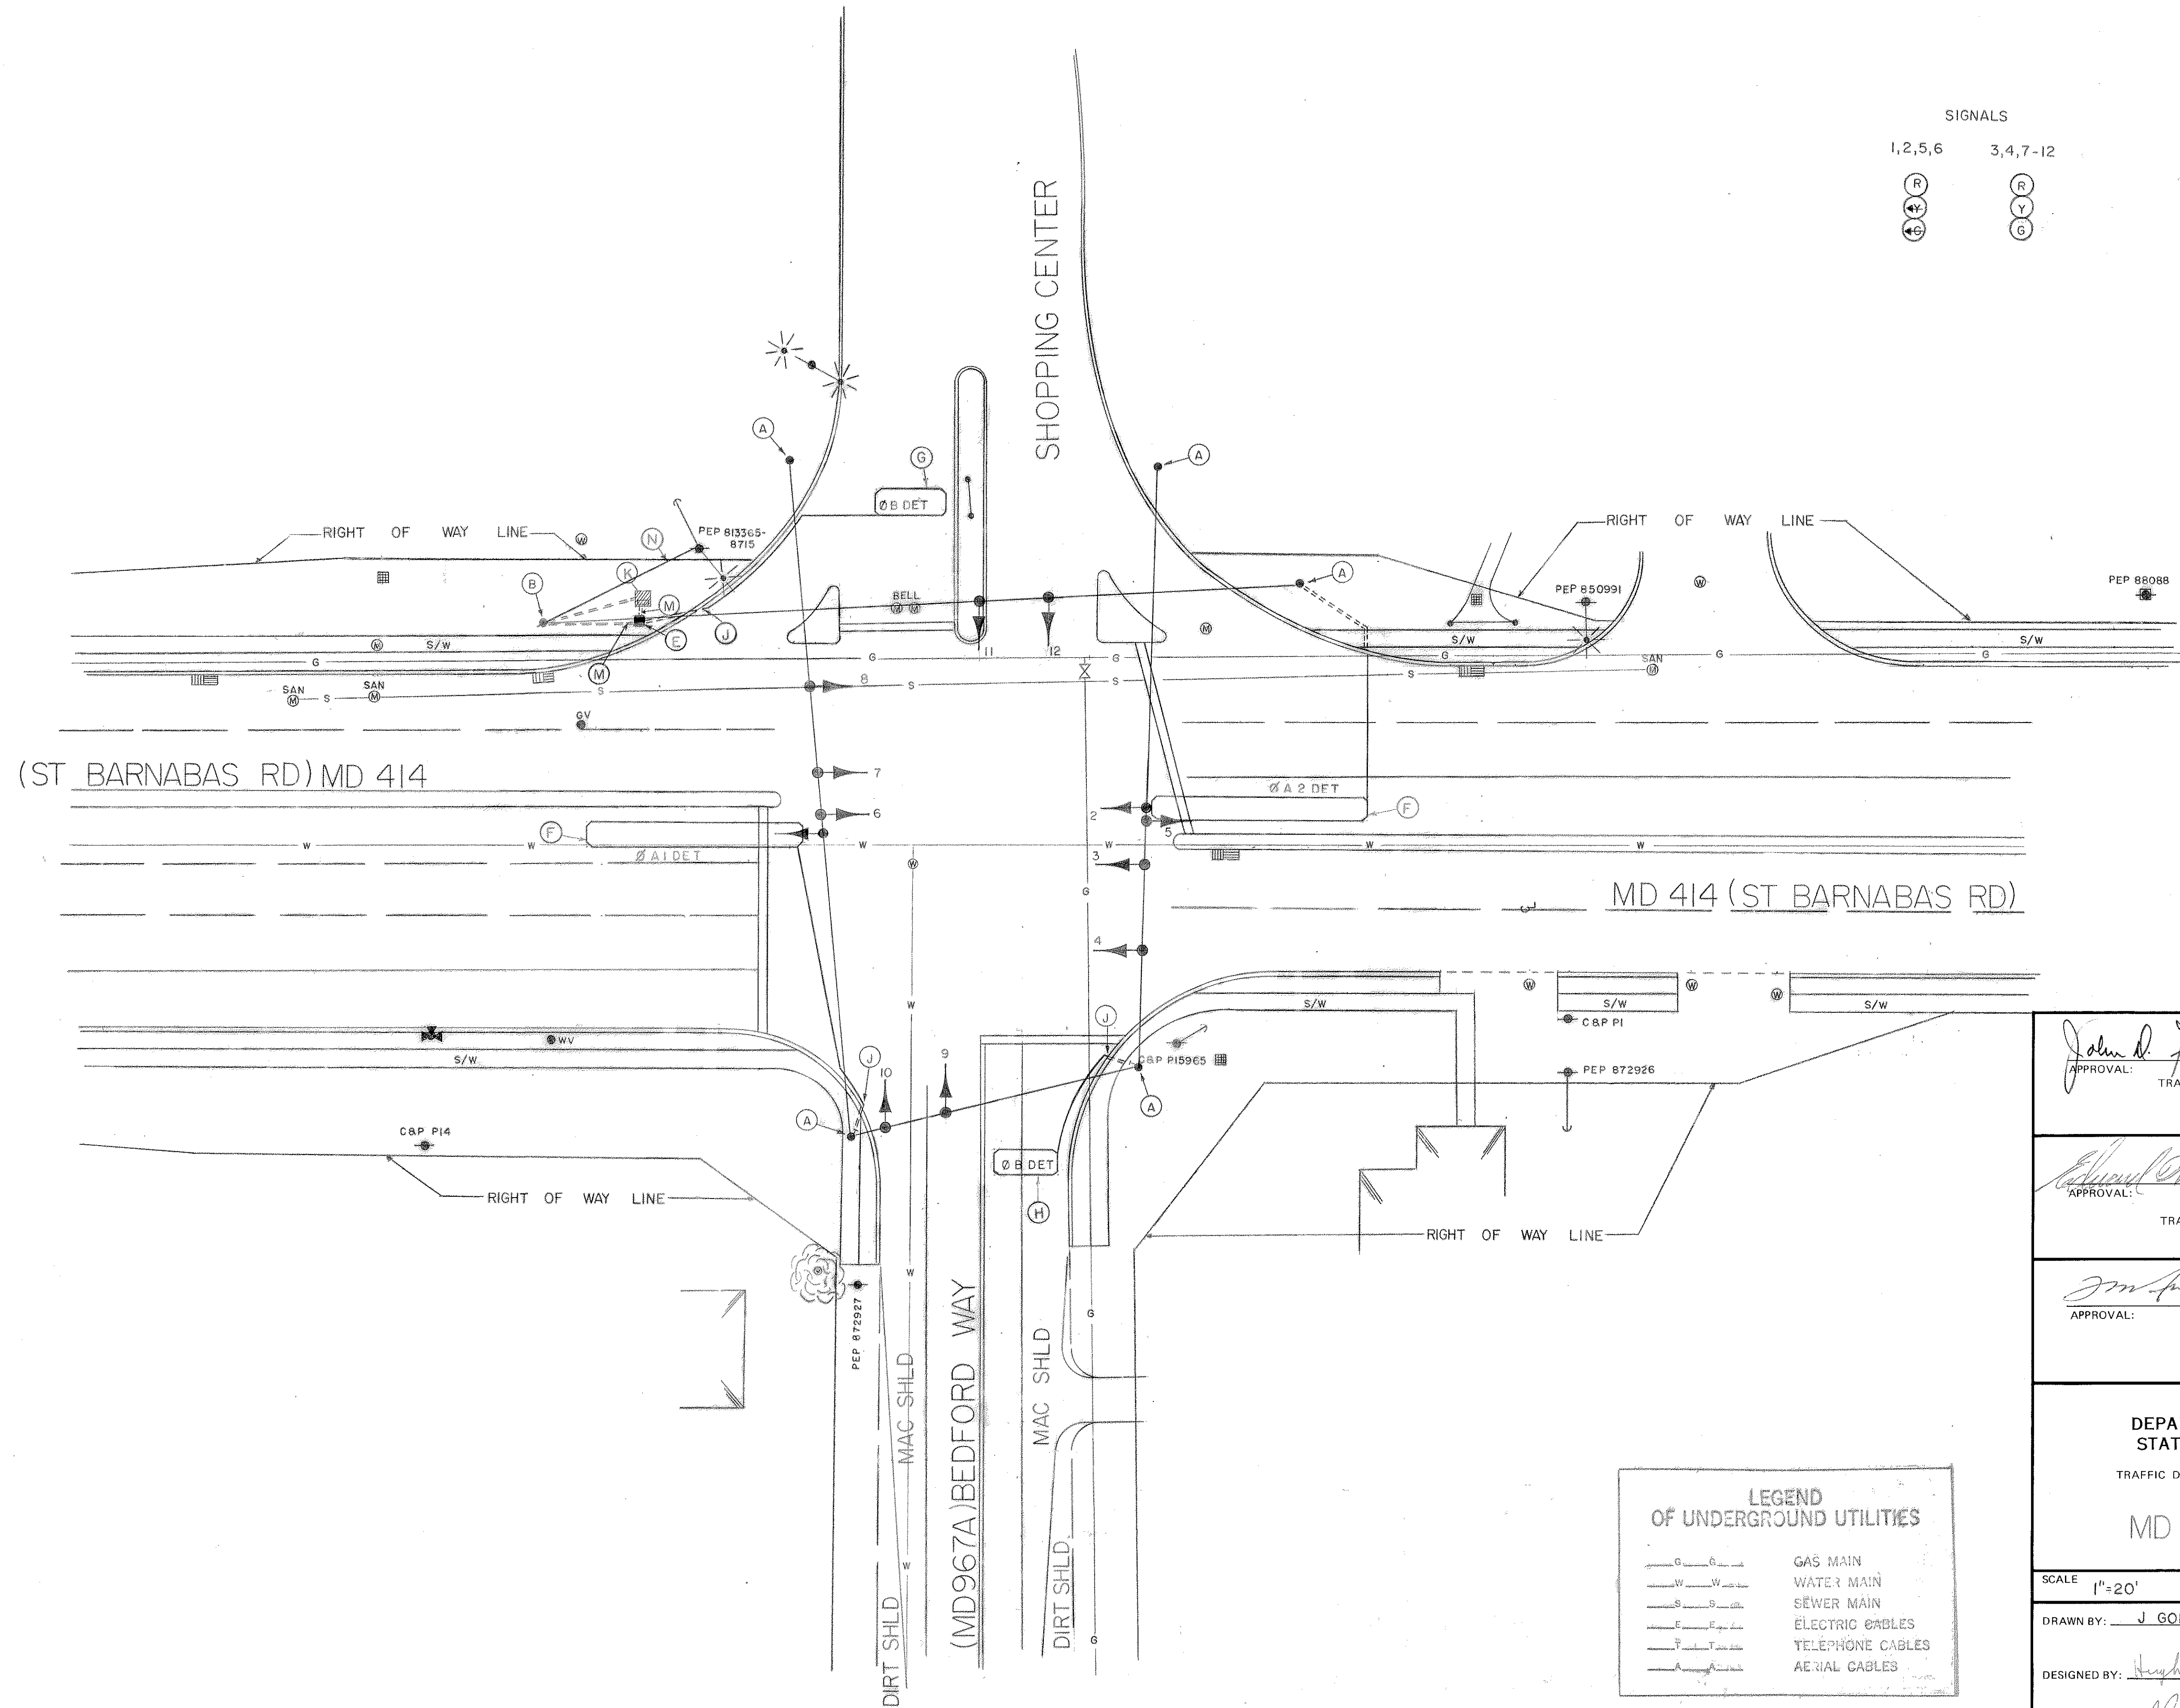

APPROVAL: *John D. Hunt* 7/27/74  
REGIONAL  
TRAFFIC ENGINEER

APPROVAL: *Edward W. Kennedy* 2/28/74  
CHIEF BUREAU  
OF  
TRAFFIC ENGINEERING

APPROVAL: *J. M. Pitts* 2/20/74  
ASST. CHIEF ENGINEER  
TRAFFIC

7-2-80  
OLD CONTRACT NO.  
P 365X-000-385  
ASBUILT

REVISIONS

STATE OF MARYLAND  
DEPARTMENT OF TRANSPORTATION  
STATE HIGHWAY ADMINISTRATION  
TRAFFIC DIVISION - BUREAU OF TRAFFIC ENGINEERING

MD 414 & BEDFORD WAY

SCALE 1"=20' DATE 4-27-73 CONTRACT NO.

DRAWN BY: J. GORDON COUNTY: PRINCE GEORGE

DESIGNED BY: *Hugh J. Reinhardt* SIGNAL NO.: 16319

CHECKED BY: *AB* DRAWING NO. TS-898A

LEGEND OF UNDERGROUND UTILITIES	
— G — G —	GAS MAIN
— W — W —	WATER MAIN
— S — S —	SEWER MAIN
— E — E —	ELECTRIC CABLES
— T — T —	TELEPHONE CABLES
— A — A —	AERIAL CABLES